

Brookhaven National Laboratory
Plant Engineering - E&CS Division
Engineering Change Notice Form

PROJECT: CCWF II

JOB No. 11705

ECN Title: Steam and Condensate Piping

ECN No. 20

Affected Documents: Drawings MP-100, MP-304, MP-305, MH-600

Requested Change (Attach sketch if applicable): Modify steam and condensate routing to reduce congestion in the pipe tunnel.

Requested by: A. Raphael

Date: 1/5/10

Resolution: Modify piping per attached marked up copy of MH-600. Add condensate flash tank to capture HPC returns- Armstrong R4 (24" diameter) or approved equal as shown on drawing.

Approvals: A/E or Proj. Eng.: 
Project Coordinator: 
Manager:

Date: 1/15/10

Date: 1/15/10

Date:

Contractor shall take the following action:



- Await change order from P&PM
- Proceed with change as described
- Provide cost proposal for change as described

Distribution: E. W. Howell
E&U
O&M
NSLS II

Giffels
MPO
DOE
ECN File

PPM

Horizontal Flash Recovery Vessels

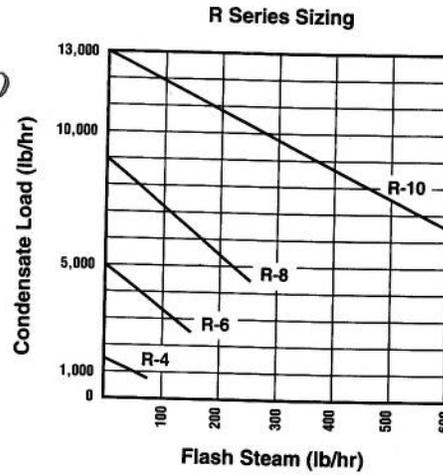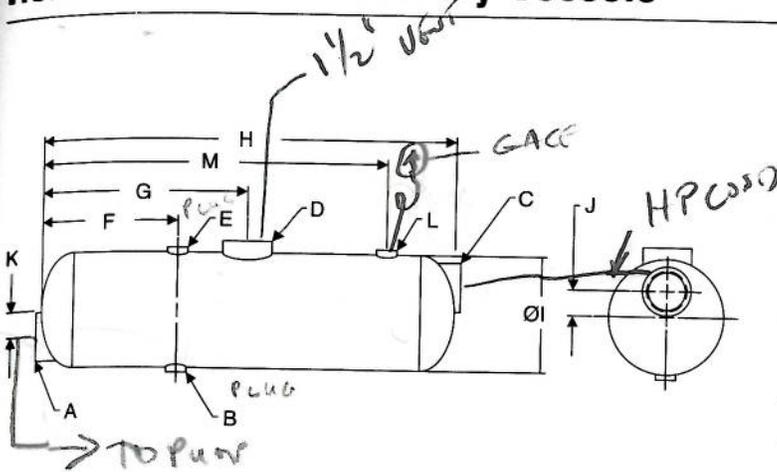

Condensate Recovery Equipment

Features

- ASME coded and stamped vessels
- Standard pressure rating 150 psi (other pressure ratings available upon request)
- Standard models are designed and sized to cover a wide range of applications and loads
- Flash vessels are designed to provide low velocity flash steam with no water carryover
- Quick payback for flash recovery investment
- **Special tanks available upon request**
- R-Series horizontal flash tanks for low flash load applications.

For a fully detailed certified drawing, refer to CDF #1038.

Flash Steam Savings Analysis

Part I: Determining the amount of flash steam produced

- A. Condensate Load $A = \text{_____ lb/hr.}$
- B. Annual hours of operation $B = \text{_____ hrs/yr.}$
- C. Steam Cost $C = \text{_____ \$/1,000 lbs.}$
- D. Flash steam percentage from chart (on page CRE-41) $D = \text{_____ \%}$
- E. Flash steam produced:
 $D \times A = \text{flash steam produced}$ $E = \text{_____ lb/hr.}$

Physical Data—Standard Design Model AFT

Model No.	R-10		R-8		R-6		R-4	
	in	mm	in	mm	in	mm	in	mm
A	3	76	2	50	1-1/2	38	1-1/2	38
B	1	25	1	25	1	25	1	25
C	3	76	2	50	1-1/2	38	1-1/2	38
D	3	76	2-1/2	64	2	50	1-1/2	38
E	1	25	1	25	1	25	1	25
F	12	305	12	305	12	305	8	203
G	18	457	18	457	18	457	12	305
H	36	914	36	914	36	914	24	610
I	10	254	8	203	6	152	4	102
J	2-1/4	57	1-3/4	44	1-1/4	32	1	25
K	2-1/4	57	1-3/4	44	1-1/4	32	1	25
L	1	25	1	25	1	25	1	25
M	30	762	30	762	30	762	18	457

NOTE: All flash tanks are ASME coded for 150 psig (10 bar). Special sizes and connections available upon request.

Part II: Determining dollar value of the flash steam

- F. Annual flash steam savings:

$$F = \frac{E \times B \times C}{1,000}$$
 $F = \text{_____ \$/yr.}$

NOTES


1. Models are ASME SEC. VIII "U" stamped for 150 psig
2. All connections are FNPT.

Capacities—Standard Design Model AFT

Model No.	Maximum Condensate Load	
	lb/hr	kg/hr
R-10	13,000	5,897
R-8	9,000	4,082
R-6	5,000	2,268
R-4	1,500	680

All dimensions and weights are approximate. Use certified print for exact dimensions. Design and materials are subject to change without notice.

Date (mm-dd-yyyy)	Issued For	Rev.
12-07-2007	TITLE # DESIGN 30% REVIEW SUBMITTAL	C
03-28-2008	TITLE # DESIGN 60% REVIEW SUBMITTAL	D
07-31-2008	TITLE # DESIGN 90% REVIEW SUBMITTAL	E
08-25-2008	TITLE # DESIGN 100% OWNER REVIEW	F
02-19-2009	TITLE # CONSTRUCTION BID ISSUE	0

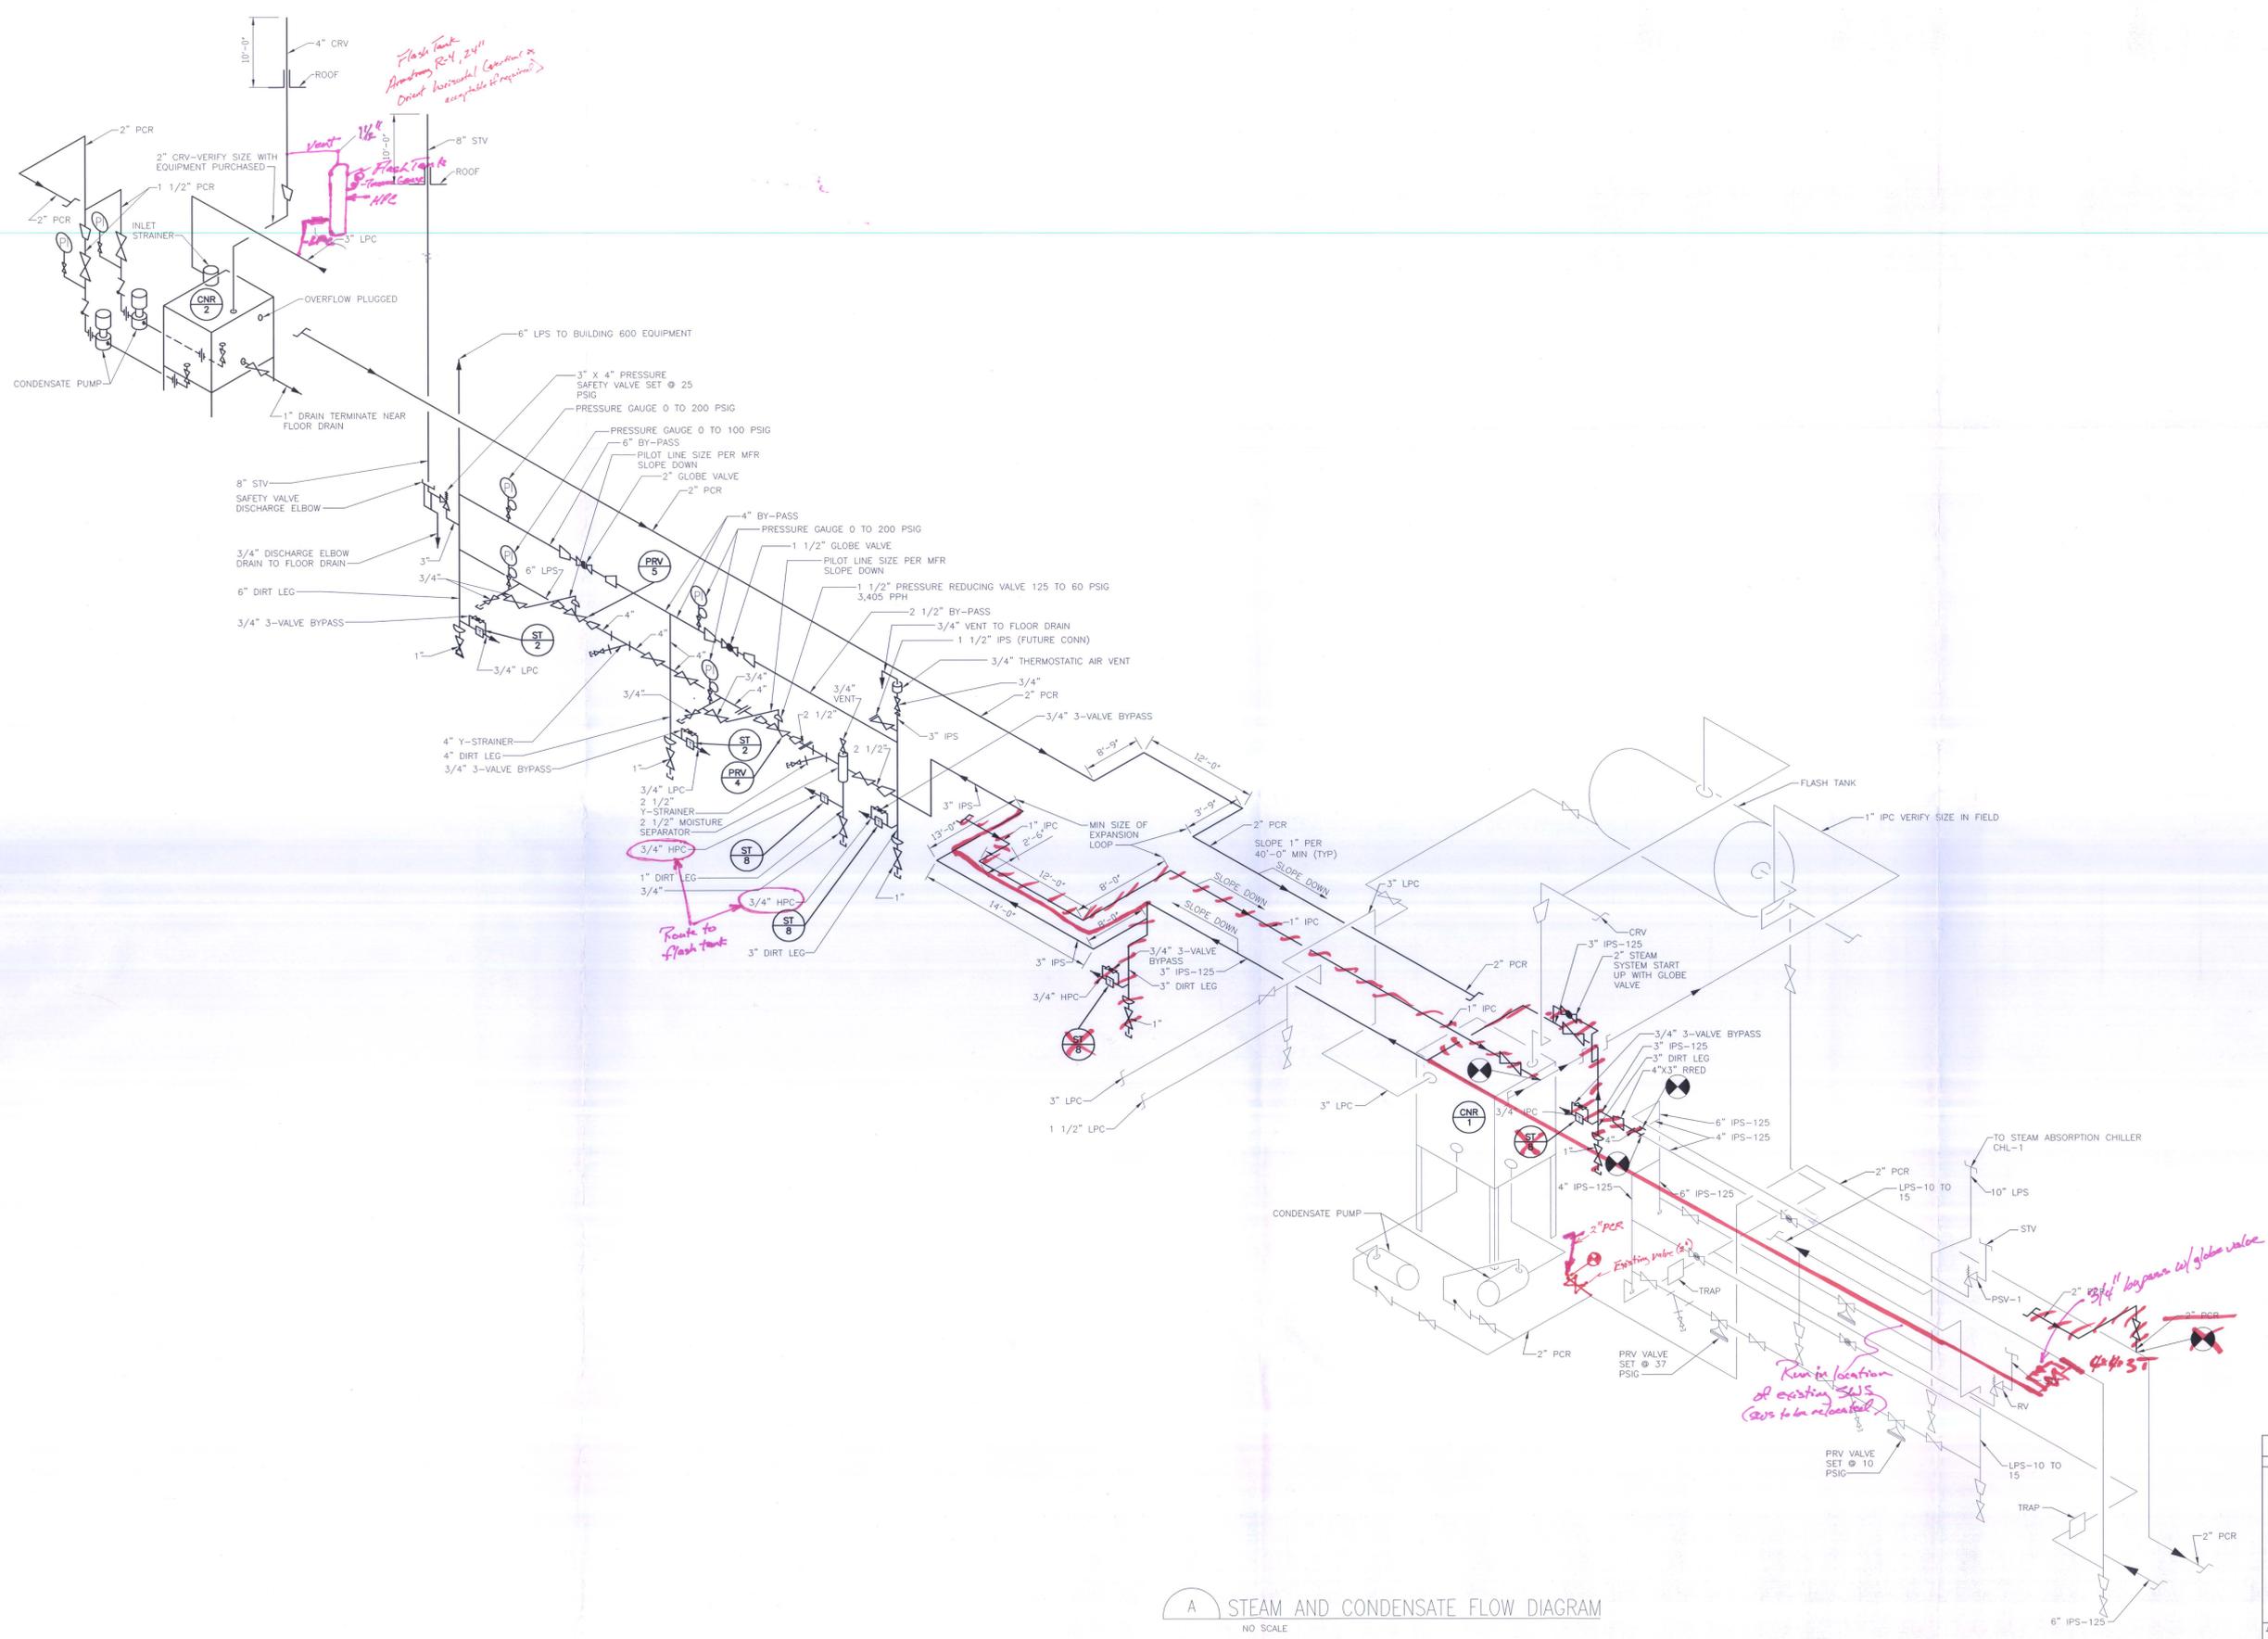

A STEAM AND CONDENSATE FLOW DIAGRAM
NO SCALE

LEGEND
 ——— EXISTING
 ——— NEW

Giffels, Partnership
 25200 Telegraph Road, Suite 200
 Southfield, Michigan 48033 USA
 Tel: 248-936-3000
 Fax: 248-936-8111

Approved By: B. NEWMAN
 Project Manager: C. KAPLAN
 Project Engineer/Architect: E. ENDEL
 Project No.: SFO70003

This drawing has been prepared solely for the use of Brookhaven National Laboratory and there are no representations of any kind made by Giffels, Partnership to any party with which Giffels, Partnership has not entered into a contract.
 This drawing shall not be used for construction purposes until the seal and signature of the responsible registered architect on the drawing and proper permit stamps and related fees are transmitted by the Owner, Owner's Agent or Contractor to the Authority Having Jurisdiction.

JOB NO. SHEET NO. REVISION		DATE	DWG.	APP'D.	QA
BROOKHAVEN NATIONAL LABORATORY					
UNDER CONTRACT WITH UNITED STATES DEPARTMENT OF ENERGY PLANT ENGINEERING DIVISION UPTON, NEW YORK 11973					
JOB TITLE CENTRAL CHILLED WATER FACILITY PHASE II			DWG. TITLE STEAM AND CONDENSATE FLOW DIAGRAM		
SCALE	AS NOTED	DWG. BY EP	REV'D BY BN	JOB NO. 11705	SHEET NO. 600
ESHO RISK LEVEL		APP'D. BY W. HARRISON	BLDG. NO. 600	MH-600	
PATH:					